


ISSUE	DATE	FOR
01	02.02.10	PRELIMINARY DESIGN
02	22.02.10	PCA APPROVAL
03	26.02.10	PRELIMINARY TENDER
04	11.03.10	BUILDING APPROVAL
05	12.03.10	TENDER
06	23.03.10	INFORMATION
07	30.03.10	BUILDING APPROVAL
A	15.04.10	CONSTRUCTION
B	16.04.10	CONSTRUCTION
C	02.07.10	CONSTRUCTION
D	23.08.10	ADDITION TO GALLERY SPACE
E	06.12.10	AS BUILT
F	22.09.14	WORKSTATION CHANGES
G	03.10.14	UPDATED SEATING LAYOUT
H	01.12.14	UPDATED SEATING LAYOUT
J	12.12.14	UPDATED SEATING LAYOUT
K	30.12.14	UPDATED SEATING LAYOUT
L	06.02.15	UPDATED SEATING LAYOUT
M	16.04.15	UPDATED SEATING LAYOUT

SERVICES CONSULTANT
AECOM
tel 02 8295 3600 fax 02 9262 5060
CERTIFYING AUTHORITY
PHILIP CHUN
tel 02 9412 2322 fax 02 9412 2433
CLIENT
BVN ARCHITECTURE

LEVEL 6, 17 YORK STREET,
SYDNEY, NSW 2000
tel 02 8297 7200 fax 02 8297 7299
PROJECT
BVN SYDNEY STUDIO

LEVEL 11, 255 PITT STREET
SYDNEY, NSW 2000
BVN PROJECT NUMBER

OHS0001
DRAWING KEY

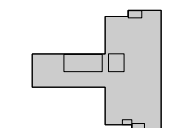

TRUE NORTH PROJECT NORTH


GRAPHIC SCALE
0 2000 5000

SCALE
1:100 at B1 DO NOT SCALE

STATUS
CONSTRUCTION
DRAWING

LEVEL 11
GENERAL ARRANGEMENT
PLAN

DRAWING NUMBER ISSUE
D_00 M

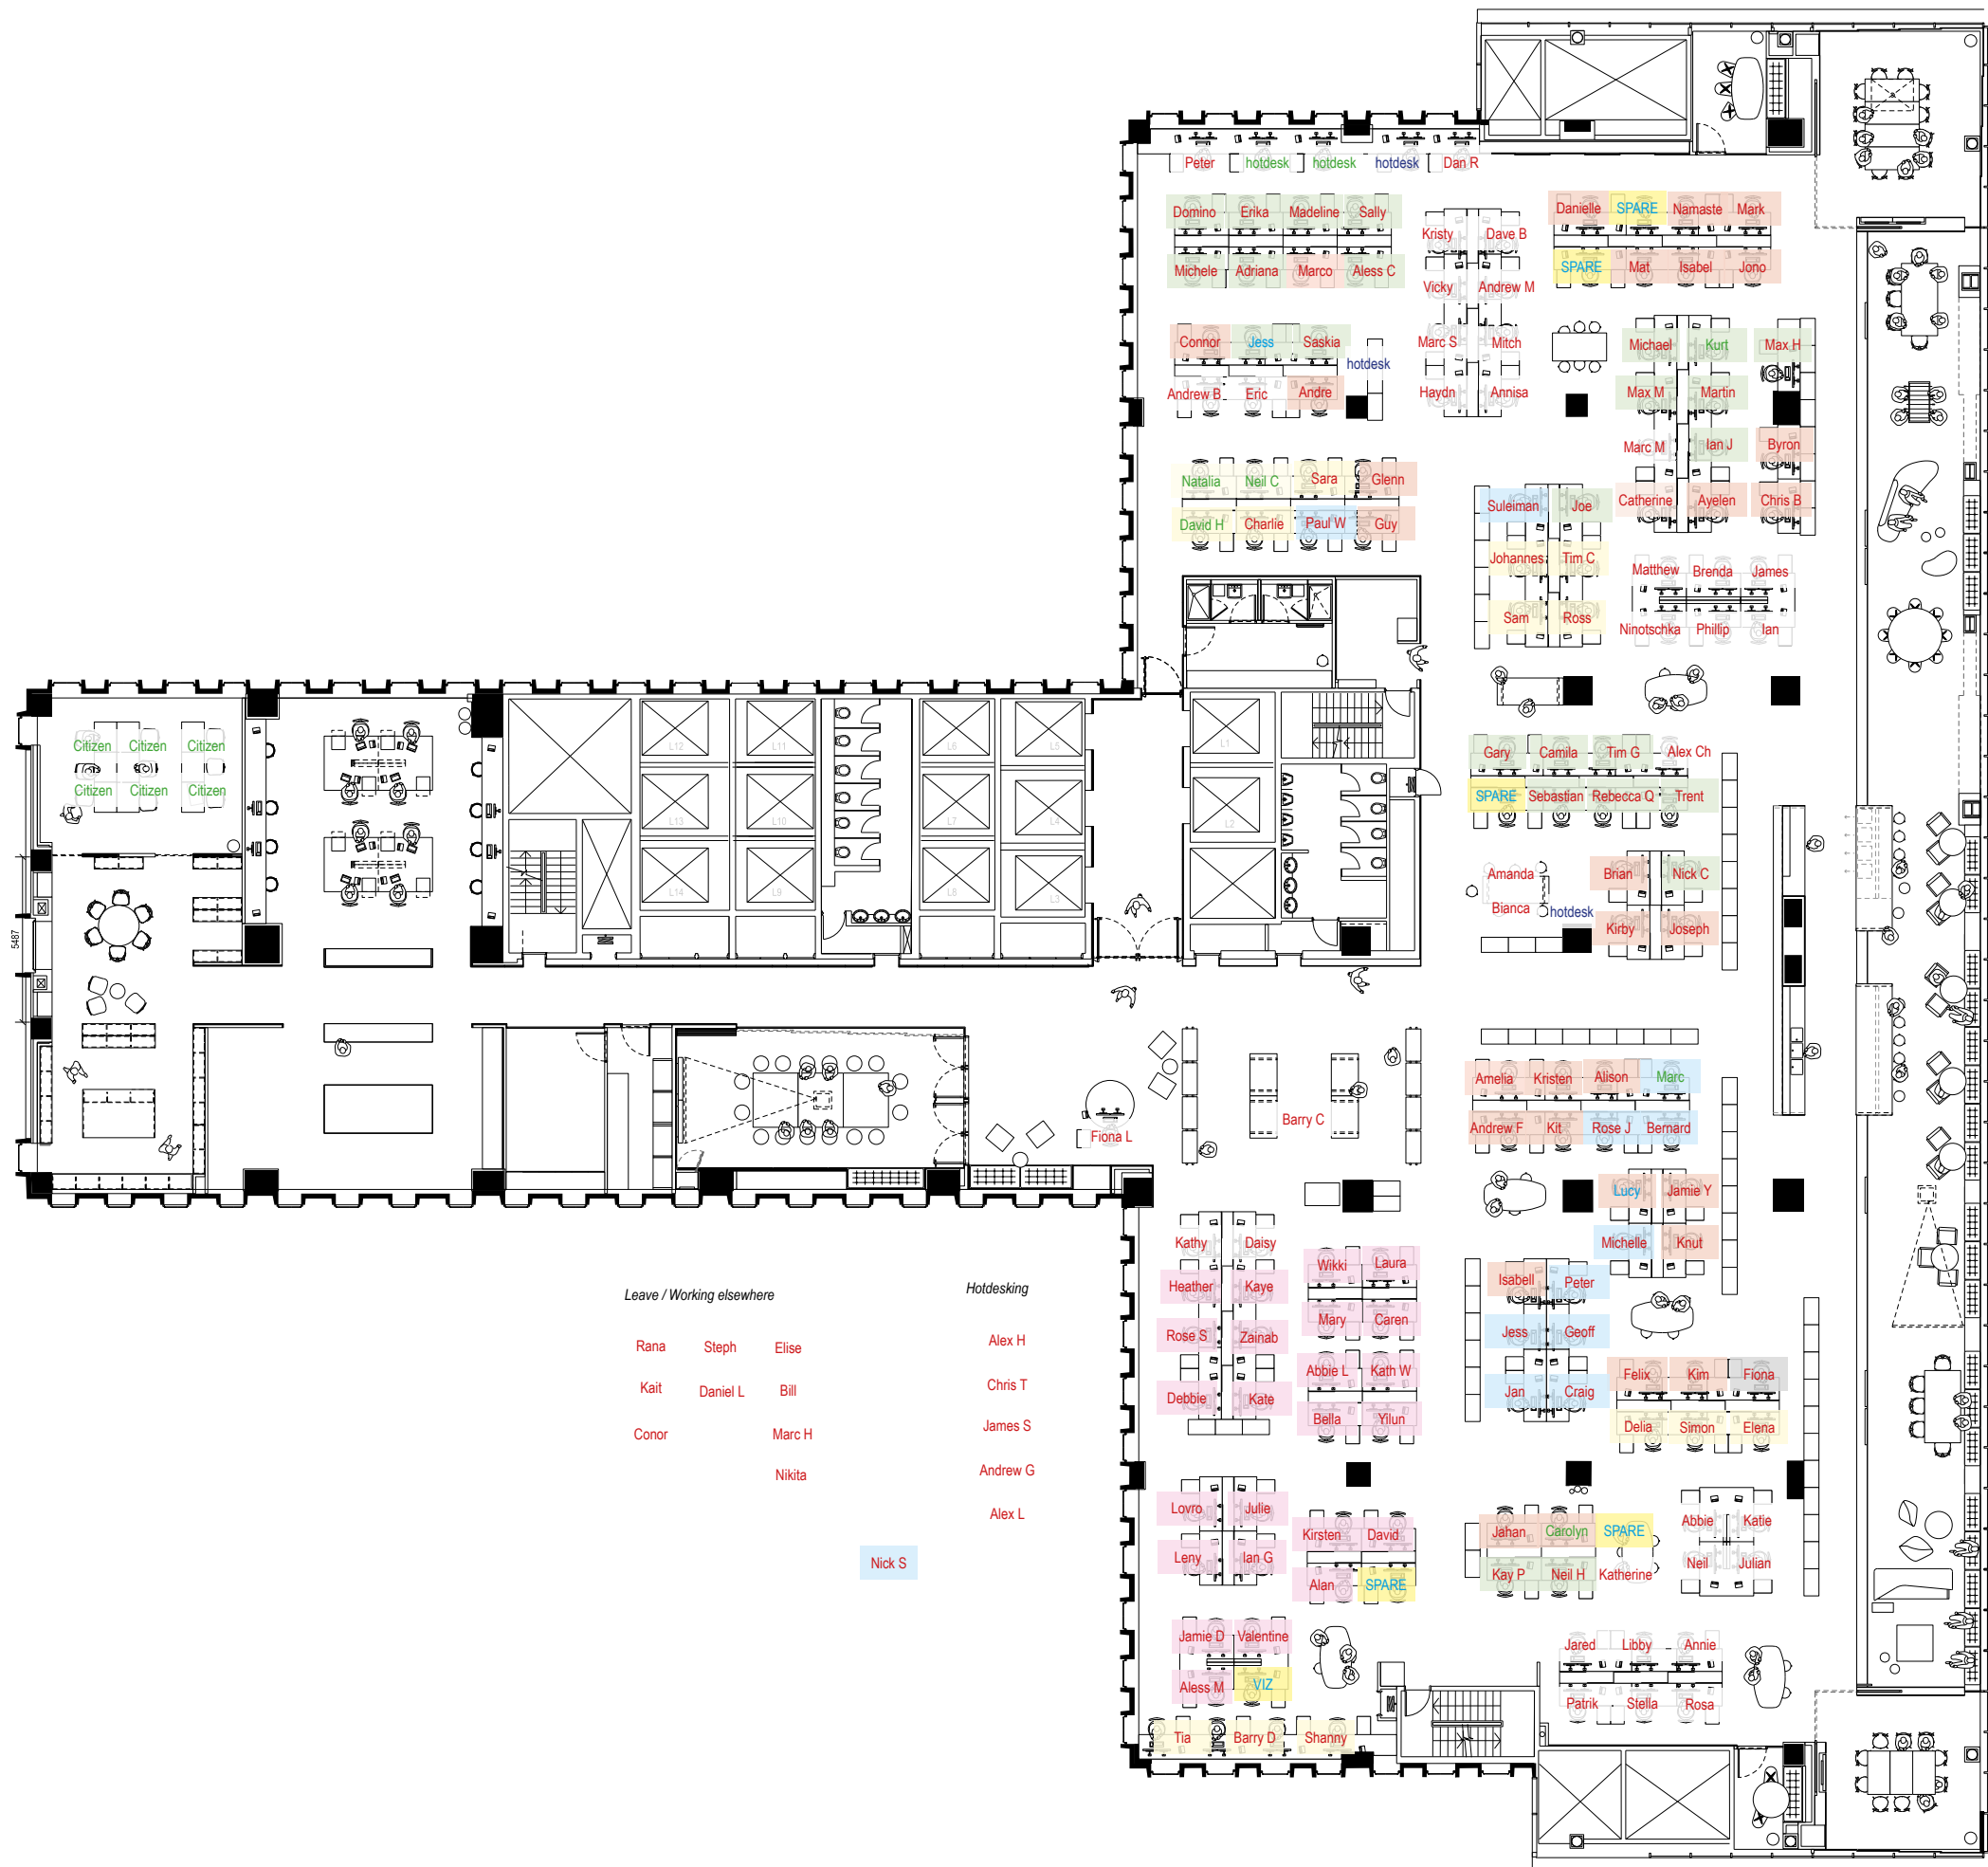

Leave / Working elsewhere

Rana Steph Elise
Kait Daniel L Bill
Conor Marc H
Nikita

Hotdesking

Alex H
Chris T
James S
Andrew G
Alex L

Nick S

James D